
VALHALLA DE TORTUGA

Interior arrangement - confirmed layout

Source: IMG_1549.mp4 + Raul Silvas corrections | Room assignments updated; dimensions remain unmeasured

REV C: exterior reference and schematic deck arrangement added on sheet 03; confirmed interior layout retained.
Dashed teal areas show planned starboard fridges and navigation station. Room geometry is schematic; no measured scale.

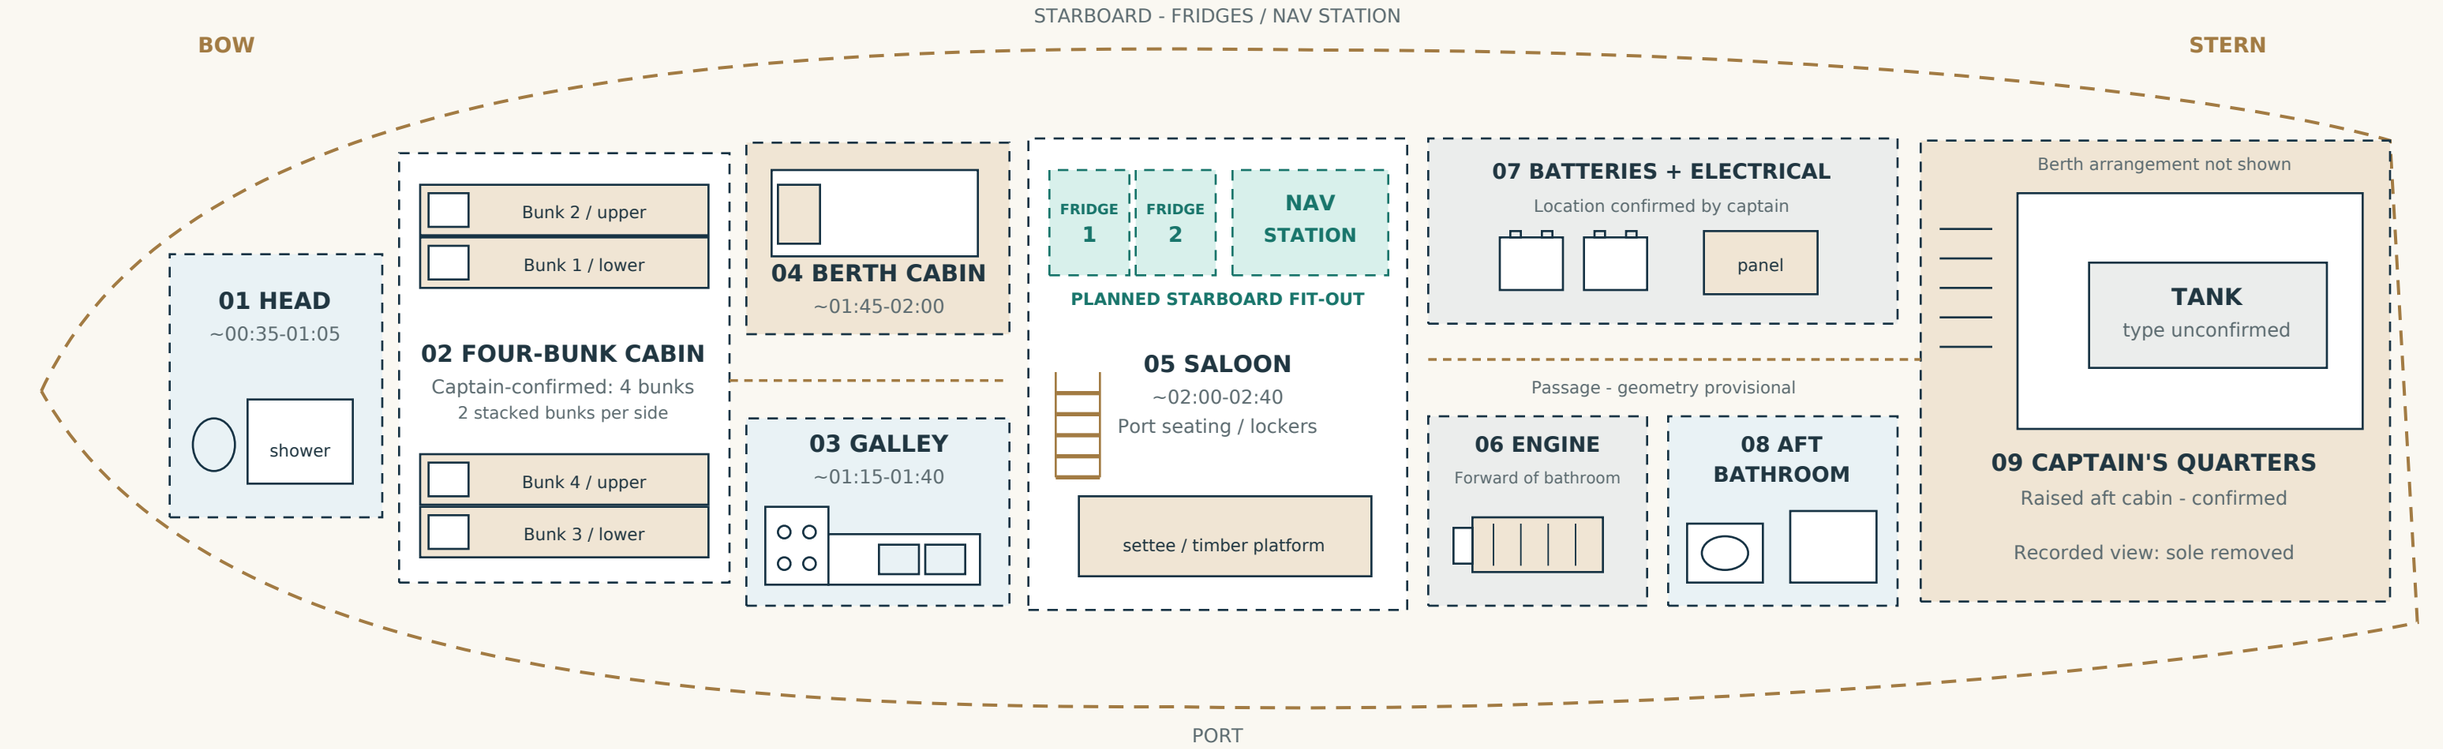

CAPTAIN-CONFIRMED CORRECTIONS

Forward cabin: four bunks. Raised aft area: captain's quarters. Engine: forward of the aft bathroom. Batteries/electrical: in the former engine position on Rev A. These corrections govern this revision.

WHAT IS STILL INFERRED

Exact room boundaries, doorways, passage widths; equipment footprints and relative room sizes; tank identification and captain's berth arrangement. Dashed boundaries and hull envelope are schematic.

PLANNED STARBOARD FIT-OUT

Two ICECO VL75ProD fridges in the starboard saloon. Navigation station forward of battery/electrical room. Unit orientation and service clearances unresolved. Teal: planned fit-out; shown positions unmeasured.

REFERENCE ONLY Project baseline: 55 ft length and 14.5 ft beam. These have NOT been used to scale the interior. Interior: sheets 01-02. Exterior reference and deck arrangement: sheet 03. Not an as-built survey.

VALHALLA DE TORTUGA

Visual evidence from the walkthrough

Video frames + captain corrections | Captions distinguish recorded condition, confirmed rooms and planned starboard fit-out




01 Head / shower

View at 00:45

Toilet compartment visible.
Shower pan and bench appear
in the following camera sweep.

Review interval 00:35-01:05

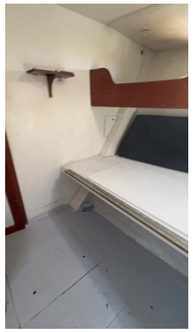

02 Four-bunk cabin

View at 00:15

Captain confirms four bunks.
Upper and lower bunks on
both sides of the forward cabin.

Review interval 00:00-00:35




03 Galley

View at 01:22

Range / oven, double sink,
worktops and lockers visible.
Shows recorded equipment.

Review interval 01:15-01:40

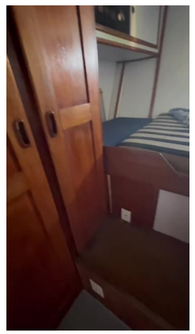

04 Separate berth cabin

View at 01:48

Raised mattress platform,
under-berth access and timber
door / cabinet surfaces visible.

Review interval 01:45-02:00



05 Saloon

View at 02:03

Video shows the earlier saloon.
Planned: two starboard fridges;
nav station ahead of batteries.

Review interval 02:00-02:40



06 Engine space

View at 02:55

Engine visible in the walkthrough.
Captain locates it forward of
the aft bathroom; plan corrected.

Review interval 02:40-03:20




07 Batteries / electrical

View at 03:35

Panel shown in this frame.
Captain places batteries/electrics
in Rev A's former engine area.

Review interval 03:20-03:55

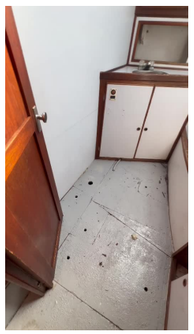

08 Aft bathroom

View at 03:58

Basin and shower pan visible.
Captain confirms engine is
forward of this aft bathroom.

Review interval 03:55-04:20



09 Captain's quarters

View at 05:05

Captain identifies this raised
aft area as his quarters.
Exposed tank type unverified.

Review interval 04:20-05:53

VALHALLA DE TORTUGA

Exterior reference + deck arrangement

User-supplied exterior image | Visual design reference; dimensions and completed installation status unverified



EXTERIOR FEATURES INCORPORATED

1 BOWSPRIT + BOW ACCESS

Projecting timber platform and bow rails shown.
Added to the schematic exterior footprint below.

2 OPEN TEAK DECK

Broad working deck, hatch coamings and timber details.
Hatch positions are indicative; room alignment unmeasured.

3 SINGLE MAST

Mast shown ahead of the raised aft structure.
Exact mast station is not derived from this perspective.

4 RAISED AFT CABIN

Related to the captain-confirmed aft quarters on sheet 01.
Cabin sides and windows inform the exterior representation.

5 HARDTOP + SOLAR

Timber-edged roof with solar above the aft area.
Retain planned 6 fixed + 2 sliding panels; image cannot verify count.


6 AFT PROJECTION

Shown as an aft projection / planned boomkin reference.
Dimensions and attachment details remain unverified.

CONFIRMED INTERIOR REMAINS THE BASIS
The exterior view does not determine hidden room or equipment positions.

DECK ARRANGEMENT - SCHEMATIC TOP VIEW

Bow left / stern right | Not to scale | Stations approximate

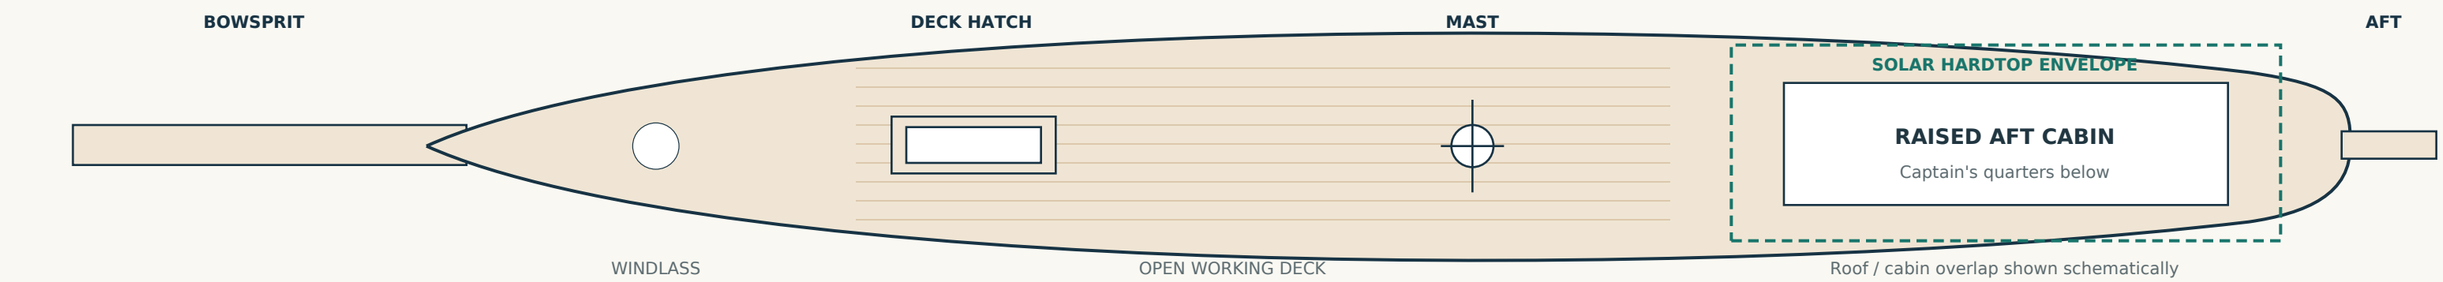

Source image: A9234624-8841-47BE-A693-4FDC9ED08565(2).jpeg. Photograph annotations are reference keys only.